CANADIAN PACIFIC

SOLSQUA - TRANS CANADA HIGHWAY CROSSING ROAD RELOCATION

MOUNTAIN DIVISION SHUSWAP SUBDIVISION

ISSUED FOR CONSTRUCTION - REVISED




MAY 7, 2018

ΗΔΤΟΗ

Dirkmittor Dirk Control Dirk Control Dirk Control Dirk Control 2822-000-HIN-002 Downing List Mol LEGRID 9 2018.05.07 2822-000-HIN-002 Dirk Mob PLAN AND PROFILE SIL, 0+100 TO SIL, 0+120 6 2018.05.07 2822-000-HIN-002 Link Robo PLAN AND PROFILE SIL, 0+200 TO SIL, 0+278 5 2018.05.27 2822-000-HPF-103 Link Robo PLAN AND PROFILE SIL, 0+200 TO SIL, 0+278 5 2018.05.22 2822-000-HPF-104 TINKE CAMAA WEENKE PLAN AND PROFILE SIL, 101/107 OSIL, 10-470 6 2018.05.22 2822-000-HPF-104 TINKE CAMAA WEENKE PLAN AND PROFILE SIL, 101/107 OSIL, 10-470 5 2018.05.22 2822-000-HPF-106 TINKE CAMAA WEENKE PLAN AND PROFILE SIL, 101/107 OSIL, 10-420 5 2018.05.22 2822-000-HPF-107 TOWE CAMAA WEENKE PLAN AND PROFILE SIL, 101/107 OSIL, 01-120 5 2018.05.22 2822-000-HPF-108 PROFILE SIL, 104/80 OSI SIL, 01-120 5 2018.05.22 2822-000-HFF-201 UNK ROJO PARAMIT MARKINGS AND SIGNACE SIL, 01-100 OSIL, 01-120 5 2018.05.22 2822-000-HFF-201 UNK ROJO PARAMIT MARKINGS AND SIGNACE SIL, 10+100 OSIL, 01-130 5 2018.05.23	DRAWING NO.	DESCRIPTION	REVISION	DATE	
3332-PRO-HIN-022 SPANING LIST AND LEERND 1 231826-07 33320-DRG-PRI-PC03 KCY PLAN RAD PLAN AND PROFILE STA, 0+000 TO STA, 0+240 6 2018.04.27 33320-DRG-PRI-PC12 LIJK KRAD PLAN AND PROFILE STA, 0+120 TO STA, 0+240 6 2018.04.27 33320-DRG-PRI-PC12 LIJK KRAD PLAN AND PROFILE STA, 0+120 TO STA, 0+240 5 2018.03.22 33320-DRG-PRI-PC14 TRANE CAMADA MODENING PLAN AND PROFILE STA, 10+170 6 2018.03.22 33320-DRG-PRI-PC14 TRANE CAMADA MODENING PLAN AND PROFILE STA, 10+170 6 2018.03.22 33320-DRG-PRI-T04 TRANE CAMADA MODENING PLAN AND PROFILE STA, 10+170 6 2018.03.22 33320-DRG-PRI-T03 TRANE CAMADA MODENING PLAN AND PROFILE STA, 10+1010 STA, 10+20 6 2018.03.22 33320-DRG-PRI-T03 SUSSIDIA CAMADA MODENING PLAN AND PROFILE STA, 0+120 TO STA, 0+120 1 2 2018.02.28 33320-DRG-PRI-D13 LIJK RAND PARAMER PARAL STA SUSSIDIA STA, 10+0010 STA, 0+120 1 2 2018.02.28 33320-DRG-PRI-D23 LIJK RAND PARAMER SAND SIGNAGE STA, 0+1201 TO STA, 10+120 5 2018.02.28 33320-DRG-PRI-D23 LIJK RAND PARAMER MERGES AND SIGNAGE STA, 0+120			~~~~~~~~~~~~~~~~~~~~~~~~~~~~~~~~~~~~~~~		~~~~~~~~~~~~~~~~~~~~~~~~~~~~~~~~~~~~~~~
38323-DB0-HB-603 KEY PLM 5 2016.04.27 38320-DB0-HB-603 KEY PLM 5 2016.04.27 2016.04.27 38320-DB0-FP-101 LINK ROAD PLAN AND PROFILE STA, 0420 C 2016.05.27 2016.05.27 3520-DB0-FP-103 LINK ROAD PLAN AND PROFILE STA, 0420 C 2016.05.27 5 2016.05.27 3520-DB0-FP-105 TRANS CAMDA WORNING FLAN AND PROFILE STA, 10-170 TO STA, 10+170 5 2018.05.22 3520-DB0-FP-105 TRANS CAMDA WORNING FLAN AND PROFILE STA, 10-130 TO STA, 10+180 5 2018.05.22 3520-DB0-FP-108 TRANS CAMDA WORNING FLAN AND PROFILE STA, 10-107 TO STA, 10+180 5 2018.05.22 3520-DB0-FP-108 REVERDIN MORKOW FLAN AND PROFILE T 2018.05.27 2018.05.27 3520-DB0-FP-108 REVERDIN MORKOW FLAN AND PROFILE T 2018.05.27 2018.05.27 3520-DB0-FP-108 REVERDIN MORKOW FLAN AND PROFILE STA, 0-100 TO STA, 0-100 5 2018.05.27 3520-DB0-FP-203 LINK ROAD PARALENT WORNINGS AND SIGNACE STA, 0-100 TO STA, 0-100 5 2018.05.26 3520-DB0-FW-203 LINK ROAD PARALENT WORNINGS AND SIGNACE STA, 0-100 TO STA, 10-170 <t< td=""><td></td><td></td><td>{</td><td></td><td></td></t<>			{		
3332-DNO-PP-101 LINK ROAD PLAN AND PROFILE STA. 0+000 TO STA. 0+120 6 2018.00-201 33320-DNO-PP-102 LINK ROAD PLAN AND PROFILE STA. 0+120 TO STA. 0+240 5 2018.03.22 33320-DNO-PP-104 TRANS CAMADA WOERNOE FLAN A02 DRIVESTA. 0+120 TO STA. 0+170 6 2018.03.22 33320-DNO-PP-104 TRANS CAMADA WOERNOE FLAN AND PROFILE STA. 10+200 TO STA. 10+170 6 2018.03.22 33320-DNO-PP-105 TRANS CAMADA WOERNOE FLAN AND PROFILE STA. 10+240 TO STA. 10+260 6 2018.04.27 33320-DNO-PP-105 TRANS CAMADA WOERNOE FLAN AND PROFILE STA. 10+30 TO STA. 10+265 6 2018.04.27 35320-DNO-PP-107 TRANS CAMADA WOERNOE FLAN AND PROFILE STA. 10+30 TO STA. 10+85 6 2018.04.27 35320-DNO-PP-202 LINK ROAD PAVENEET MARKINSS AND SIGNACE STA. 0+20 TO STA. 0-100 5 2018.02.28 35320-DNO-PP-202 LINK ROAD PAVENEET MARKINSS AND SIGNACE STA. 0+20 TO STA. 0-100 5 2018.02.28 35320-DNO-PP-203 LINK ROAD PAVENEET MARKINSS AND SIGNACE STA. 0+120 TO STA. 0+120 5 2018.02.28 35320-DNO-PP-204 TRANS CAMADA WOERNO MARKINSS AND SIGNACE STA. 0+120 TO STA. 0+120 5 2018.02.28 35320-DNO-PP-205 TRANS CAMADA WOERNO MA					
35330-DMC-PF-102 LINK RAND PLAN AND PROFILE STA, 0+120 10 STA, 0+240 ① ① ② ② ② ② ③ ③ ③ ○ <t< td=""><td></td><td></td><td></td><td></td><td></td></t<>					
33320-PMC-PF-103 LINK RAD PLAN AND PROFILE STA. 0-240 TO STA. 0+376 5 2018.03.22 33320-PMC-PF-104 TRANS CAMADA WDENING PLAN AND PROFILE STA. 10-000 TO STA. 10+170 6 2018.03.22 33320-PMC-PF-104 TRANS CAMADA WDENING PLAN AND PROFILE STA. 10-1400 TO STA. 10+510 6 2018.03.22 33320-PMC-PF-108 TRANS CAMADA WDENING PLAN AND PROFILE STA. 10-1401 TO STA. 10+510 6 2018.03.22 33320-PMC-PF-108 SCLISQUA ROAD PLAN AND PROFILE STA. 10-1401 TO STA. 10+655 6 2018.03.22 33320-PMC-PF-108 SCLISQUA ROAD PLANEMUNG AND SIGNAE STA. 0-100 TO STA. 04120 6 2018.03.22 33320-PMC-PF-109 INK ROAD PANAEMENT MARKINGS AND SIGNAE STA. 0-100 TO STA. 04120 5 2018.02.28 33320-PMC-PF-202 LINK ROAD PANAEMENT MARKINGS AND SIGNAE STA. 0-100 TO STA. 104170 5 2018.02.28 33320-PMC-PF-202 TRANS CAMADA WDENING MARD SIGNAE STA. 0-100 TO STA. 104170 5 2018.02.28 33320-PMC-PF-204 TRANS CAMADA WDENING MARD SIGNAE STA. 0-100 TO STA. 104170 6 2018.02.28 33320-PMC-PM-205 TRANS CAMADA WDENING MARD SIGNAE STA. 0-1400 TO STA. 104170 5 2018.02.28 33320-PMC-PM-207 TRANS CAMADA WDENING MARD S					~~~~~~~~~~~~~~~~~~~~~~~~~~~~~~~~~~~~~~~
3332-bwc-PP-104 TRANS CANADA WIDENING PLAN AND PROFILE STA. 16+000 TO STA, 16+170 6 2018.03.22 3332-bwc-PP-105 TRANS CANADA WIDENING PLAN AND PROFILE STA. 16+200 5 2018.03.22 3320-bwc-PP-105 TRANS CANADA WIDENING PLAN AND PROFILE STA. 16+200 6 2018.04.27 3320-bwc-PP-107 TRANS CANADA WIDENING PLAN AND PROFILE 7 2018.04.27 3320-bwc-PP-108 SOLSDLA ROAD PLAN AND PROFILE 6 2018.03.22 35320-bwc-PP-109 Revision Dervision FLAN AND PROFILE 6 2018.03.22 35320-bwc-PH-201 LINK ROAD PAVELINT MARKINGS MD SIGNAGE STA. 0+400 TO STA. 0+120 (3 3018.05.278 35320-bwc-PH-201 LINK ROAD PAVELINT MARKINGS MD SIGNAGE STA. 0+240 TO STA. 0+340 5 2018.02.28 35320-bwc-PH-203 TRANS CANADA WIDENING MARKINGS MD SIGNAGE STA. 0+240 TO STA. 10+300 6 2018.02.28 35320-bwc-PH-204 TRANS CANADA WIDENING MARKINGS MD SIGNAGE STA. 10+700 TO STA. 10+170 5 2018.02.28 35320-bwc-PM-205 TRANS CANADA WIDENING MARKINGS MD SIGNAGE STA. 10+170 TO STA. 10+300 6 2018.02.28 35320-bwc-PM-206 TRANS CANADA WIDENING MARKINGS MD SIGNAGE STA. 10+170 TO STA. 10+300 5					لىب
35320-bWG-PP-105 TRNIS CANADA WIDENING PLAN AND PROFILE STA. 10+170 TO STA. 10+510 6 2018.03.22 35320-DWG-PP-108 TRAKE CANADA WIDENING PLAN AND PROFILE STA. 10+540 TO STA. 10+510 6 2018.03.22 35320-DWG-PP-108 SOLSQIA, ROAD PLAN AND PROFILE STA. 10+510 TO STA. 10+685 6 2018.03.22 35320-DWG-PP-109 RENISION DIVERME FLAN AND PROFILE STA. 10+510 TO STA. 10+685 7 2018.03.22 35320-DWG-PH-109 RENISION DIVERME FLAN AND PROFILE STA. 10+510 TO STA. 0+120 1 2018.03.22 35320-DWG-PH-202 LINK ROAD PREVENT MARKINS AND SIGNACE STA. 0+100 TO STA. 0+240 4 2018.02.28 35320-DWG-PH-202 LINK ROAD PREVENT MARKINS AND SIGNACE STA. 10+120 TO STA. 10+340 6 2018.02.28 35320-DWG-PH-203 TRAKE CANADA WIDENIM MARKINS AND SIGNACE STA. 10+120 TO STA. 10+340 6 2018.02.28 35320-DWG-PH-207 TRAKE CANADA WIDENIM MARKINS AND SIGNACE STA. 10+140 TO STA. 10+540 5 2018.02.28 35320-DWG-PH-203 TRAKE CANADA WIDENIM MARKINS AND SIGNACE STA. 10+140 TO STA. 10+565 4 2018.02.28 35320-DWG-PH-203 TRAKE CANADA WIDENIM MARKINS AND SIGNACE STA. 10+100 TO STA. 10+585 4 2018.02.28 35320-DWG-PH-203					
33320-DWG-PP-108 TRANS CANADA WIDENING PLAN AND PROFILE STA. 10-4300 6 2018.04.27 35320-DWG-PP-107 TRANS CANADA WIDENING PLAN AND PROFILE 7 2018.04.27 35320-DWG-PP-108 SOLSOLD ROAD PLAN AND PROFILE 7 2018.04.27 35320-DWG-PP-109 REVISION DRIVEWY PLAN AND PROFILE 7 2018.04.27 35320-DWG-PM-201 LINK ROAD PAVEMENT MARKINS AND SIGNAGE STA. 0+120 6 2018.02.28 35320-DWG-PM-201 LINK ROAD PAVEMENT MARKINS AND SIGNAGE STA. 0+120 TO STA. 0+240 4 2018.02.28 35320-DWG-PM-203 LINK ROAD PAVEMENT MARKINS AND SIGNAGE STA. 0+120 TO STA. 0+340 5 2018.02.28 35320-DWG-PM-204 TRANS CANADA WIDENING MARKINS AND SIGNAGE STA. 10+400 TO STA. 10+310 6 2018.02.28 35320-DWG-PM-205 TRANS CANADA WIDENING MARKINS AND SIGNAGE STA. 10+400 TO STA. 10+300 6 2018.02.28 35320-DWG-PM-205 TRANS CANADA WIDENING MARKINS AND SIGNAGE STA. 10+400 TO STA. 10+310 5 2018.02.28 35320-DWG-PM-205 TRANS CANADA WIDENING MARKINS AND SIGNAGE STA. 10+400 TO STA. 10+301 5 2018.02.28 35320-DWG-PM-205 TRANS CANADA WIDENING MARKINSS AND SIGNAGE STA. 10+501 TO STA. 10+601 TO STA. 10+602					
35320-DWG-PP-107 TRNIS CANDA INDERNING PLAN AND PROFILE STA. 10+510 TO STA. 10+685 5 2018.03.22 35320-DWG-PF ROUSGUL ROAD PLAN AND PROFILE 6 2018.03.22 35320-DWG-PM-201 LINK ROAD PAVEMENT MARKINGS AND SIGNAGE STA. 0+000 TO STA. 0+120 1 2018.03.22 35320-DWG-PM-201 LINK ROAD PAVEMENT MARKINGS AND SIGNAGE STA. 0+201 TO STA. 0+380 5 2018.02.28 35320-DWG-PM-202 LINK ROAD PAVEMENT MARKINGS AND SIGNAGE STA. 0+201 TO STA. 0+380 5 2018.02.28 35320-DWG-PM-204 TRANS CANDA WDENNG MARKINGS AND SIGNAGE STA. 10+000 TO STA. 10+170 5 2018.02.28 35320-DWG-PM-205 TRANS CANDA WDENNG MARKINGS AND SIGNAGE STA. 10+401 TO STA. 10+170 5 2018.02.28 35320-DWG-PM-206 TRANS CANDA WDENNG MARKINGS AND SIGNAGE STA. 10+401 TO STA. 10+170 5 2018.02.28 35320-DWG-PM-207 TRANS CANDA WDENNG MARKINGS AND SIGNAGE STA. 10+401 TO STA. 10+170 5 2018.02.28 35320-DWG-PM-308 SOLSQUA ROAD PAVEMENT MARKINGS AND SIGNAGE STA. 10+401 TO STA. 10+170 5 2018.02.67 35320-DWG-PM-304 TRANS CANDA MURHING MARKINGS AND SIGNAGE STA. 10+401 TO STA. 10+170 5 2018.02.67 35320-DWG-FM-303 SOLSQUA R					
35320-DWC-PP-108 SOLSOLA ROAD PLAN AND PROFILE 7 2018.04.27 55320-DWC-PR-109 REVISION DRIVEWY PLAN AND PROFILE 6 2018.03.22 55320-DWC-PM-201 LINK ROAD PAVEMENT MARKINGS AND SIGNAGE STA. 0+200 TO STA. 0+240 4 2018.02.28 55320-DWC-PM-204 TANK ROAD PAVEMENT MARKINGS AND SIGNAGE STA. 0+240 TO STA. 0+380 5 2018.02.28 55320-DWC-PM-204 TANK CAHADA WIDENING MARKINGS AND SIGNAGE STA. 0+240 TO STA. 0+170 5 2018.02.28 55320-DWC-PM-205 TRANS CAHADA WIDENING MARKINGS AND SIGNAGE STA. 10+170 TO STA. 10+170 5 2018.02.28 55320-DWC-PM-204 TANK CAHADA WIDENING MARKINGS AND SIGNAGE STA. 10+170 TO STA. 10+510 5 2018.02.28 55320-DWC-PM-205 TRANS CAHADA WIDENING MARKINGS AND SIGNAGE STA. 10+510 TO STA. 10+565 4 2018.02.28 55320-DWC-PM-206 SOLSOLA ROAD PAVEMENT MARKINGS AND SIGNAGE STA. 10+510 TO STA. 10+565 4 2018.02.28 55320-DWC-PM-208 SOLSOLA ROAD PAVEMENT MARKINGS AND SIGNAGE STA. 10+510 TO STA. 10+565 4 2018.02.28 55320-DWC-PM-208 SOLSOLA ROAD INTERSECTION DETAILS 3 2018.02.27 55320-DWC-FM-209 TATAL CROSS SECTION E TAILS 3					
55320-DNG-PP-109 REVISION DRIVEWAY PLAN AND PROFILE 6 2018.03.22 55320-DNG-PM-201 LINK ROAD PAKEMENT MARKINGS AND SIGNAGE STA. 0+000 TO STA. 0+120 (1) 2018.00.28 55320-DNG-PM-203 LINK ROAD PAKEMENT MARKINGS AND SIGNAGE STA. 0+120 TO STA. 0+120 4 2018.00.28 55320-DNG-PM-203 LINK ROAD PAKEMENT MARKINGS AND SIGNAGE STA. 0+120 TO STA. 10+170 5 2018.00.28 55320-DNG-PM-204 TRANS CANADA WIDENING MARKINGS AND SIGNAGE STA. 10+170 TO STA. 10+170 5 2018.00.28 55320-DNG-PM-205 TRANS CANADA WIDENING MARKINGS AND SIGNAGE STA. 10+170 TO STA. 10+150 5 2018.00.28 55320-DNG-PM-206 TRANS CANADA WIDENING MARKINGS AND SIGNAGE STA. 10+101 TO STA. 10+150 5 2018.00.28 55320-DNG-PM-207 TRANS CANADA WIDENING MARKINGS AND SIGNAGE STA. 10+101 TO STA. 10+855 4 2018.00.22 55320-DNG-TM-208 SOSULA ROAD PAKEMENT MARKINGS AND SIGNAGE STA. 10+101 TO STA. 10+855 4 2018.00.22 55320-DNG-TM-301 TRANS CANADA MIDENING MARKINGS AND SIGNAGE STA. 10+101 TO STA. 10+1855 5 2018.00.27 55320-DNG-TM-302 TRANS CANADA MIDENING MARKINGS AND SIGNAGE STA. 10+101 TO STA. 10+1855 5 2018.00.22 55320-DNG-TM					
55320-0WG-PM-201 LINK ROAD PAVEMENT MARKINGS AND SIGNAGE STA. 0+000 TO STA. 0+120 (1.5 2018.02.03 53320-0WG-PM-203 LINK ROAD PAVEMENT MARKINGS AND SIGNAGE STA. 0+120 TO STA. 0+240 4 2018.02.28 53320-0WG-PM-204 TRANS CAMADA WIDENING MARKINGS AND SIGNAGE STA. 0+240 TO STA. 0+380 5 2018.02.28 53320-0WG-PM-204 TRANS CAMADA WIDENING MARKINGS AND SIGNAGE STA. 10+170 TO STA. 10+170 5 2018.02.28 53320-0WG-PM-205 TRANS CAMADA WIDENING MARKINGS AND SIGNAGE STA. 10+170 TO STA. 10+510 5 2018.02.28 53320-0WG-PM-207 TRANS CAMADA WIDENING MARKINGS AND SIGNAGE STA. 10+170 TO STA. 10+650 4 2018.02.28 53320-0WG-PM-207 TRANS CAMADA MIDENING MARKINGS AND SIGNAGE STA. 10+170 TO STA. 10+685 4 2018.02.28 53320-0WG-PM-201 TRANS CAMADA INTERSECTION DETAILS 4 2018.02.28 53320-0WG-DT-303 SOLSQUA ROAD INTERSECTION DETAILS 3 2018.02.28 53320-0WG-TS-401 TYPICAL CROSS SECTIONS 7 2018.03.22 53320-0WG-TS-403 TYPICAL CROSS SECTIONS 5 2018.04.27 53320-0WG-TS-403 TYPICAL CROSS SECTIONS 5 2018.04.27 5			· · · · · · · · · · · · · · · · · · ·		
35320-DWC-PM-202 LINK ROAD PAVEMENT MARKINGS AND SIGNAGE STA. 0+120 TO STA. 0+240 4 2018.02.28 35320-DWC-FM-203 LINK ROAD PAVEMENT MARKINGS AND SIGNAGE STA. 0+240 TO STA. 0+380 5 2018.02.28 35320-DWG-FM-204 TRANS CANADA WIDENING MARKINGS AND SIGNAGE STA. 10+170 TO STA. 10+170 5 2018.02.28 35320-DWG-FM-205 TRANS CANADA WIDENING MARKINGS AND SIGNAGE STA. 10+170 TO STA. 10+150 6 2018.02.28 35320-DWG-FM-206 TRANS CANADA WIDENING MARKINGS AND SIGNAGE STA. 10+510 TO STA. 10+510 5 2018.02.28 35320-DWG-FM-207 TRANS CANADA WIDENING MARKINGS AND SIGNAGE STA. 10+510 TO STA. 10+655 4 2018.02.28 35320-DWG-FM-208 SOLSOUA ROAD INVERSIMENT MARKINGS AND SIGNAGE STA. 10+510 TO STA. 10+655 4 2018.02.28 35320-DWG-TM-304 TRANS CANADA INTERSECTION DETALS 3 2018.04.27 35320-DWG-TM-304 TYPICAL CROSS SECTIONS 7 2018.04.27 35320-DWG-TM-402 TYPICAL CROSS SECTIONS 5 2018.04.27 35320-DWG-TM-402 TYPICAL CROSS SECTIONS 5 2018.04.27 35320-DWG-TM-403 TYPICAL CROSS SECTIONS 5 2018.04.27 35320-DWG-T					~~~~
5320-DWG-PM-203 LINK ROAD PAVEMENT MARKINGS AND SIGNAGE STA. 0+240 TO STA. 0+380 5 2018.02.28 5320-DWG-PM-204 TRANS CANADA WIDENNG MARKINGS AND SIGNAGE STA. 10+000 TO STA. 10+170 5 2018.02.28 5320-DWG-PM-205 TRANS CANADA WIDENNG MARKINGS AND SIGNAGE STA. 10+400 TO STA. 10+510 5 2018.02.28 5320-DWG-PM-206 TRANS CANADA WIDENNG MARKINGS AND SIGNAGE STA. 10+310 TO STA. 10+6150 5 2018.02.28 5320-DWG-PM-207 TRANS CANADA WIDENNG MARKINGS AND SIGNAGE STA. 10+310 TO STA. 10+685 4 2018.02.28 5320-DWG-FM-208 SOLSQUA ROAD PAVEMENT MARKINGS AND SIGNAGE STA. 10+310 TO STA. 10+685 4 2018.02.28 5320-DWG-FM-301 RALWAY CROSSING PLAN 4 2018.02.28 5320-DWG-TG-301 RALWAY CROSSING PLAN 4 2018.02.28 5320-DWG-TG-302 TRANS CANADA INTERSECTION DETALS 3 2018.02.28 5320-DWG-TG-304 LINK DRIVERSY INTERSECTION DETALS 3 2018.03.22 5320-DWG-TS-403 TYPICAL CROSS SECTIONS 6 2018.04.27 5320-DWG-TS-403 TYPICAL CROSS SECTIONS 5 2018.04.27 5320-DWG-TS-403 TYPICAL CROSS SECTIONS					لس
53320-DWG-PM-204 TRANS CANADA WIDENING MARKINGS AND SIGNAGE STA. 10+100 TO STA. 10+340 5 2018.02.28 53320-DWG-PM-205 TRANS CANADA WIDENING MARKINGS AND SIGNAGE STA. 10+170 TO STA. 10+340 6 2018.02.28 35320-DWG-PM-206 TRANS CANADA WIDENING MARKINGS AND SIGNAGE STA. 10+310 TO STA. 10+350 5 2018.02.28 35320-DWG-PM-207 TRANS CANADA WIDENING MARKINGS AND SIGNAGE STA. 10+310 TO STA. 10+6510 5 2018.02.28 5320-DWG-PM-208 SOLSQUA ROAD PAVENENT MARKINGS AND SIGNAGE (7 2018.02.28 5320-DWG-CR-301 RAILWAY CROSSING PLAN 4 2018.02.28 5320-DWG-DT-302 TRANS CANADA WIDERNECTION DETALS 4 2018.02.28 5320-DWG-TS-401 TYPICAL CROSS SECTIONS 7 2018.03.22 5320-DWG-TS-402 TYPICAL CROSS SECTIONS 5 2018.04.27 5320-DWG-TS-403 TYPICAL CROSS SECTIONS 5 2018.04.27 5320-DWG-TS-403 TYPICAL CROSS SECTIONS 5 2018.04.27 5320-DWG-TS-403 TYPICAL CROSS SECTIONS 5 2018.04.27 5320-DWG-RN-503 SOLSQUA ROAD REMOVAL PLAN STA. 10+030 TO STA. 10+360 5 2018.04.27					
TRANS CANADA WIDENING MARKINGS AND SIGNAGE STA. 10+170 TO STA. 10+340 6 2018.02.28 35320-DWG-PM-205 TRANS CANADA WIDENING MARKINGS AND SIGNAGE STA. 10+540 TO STA. 10+685 4 2018.02.28 35320-DWG-PM-208 SOLSQUA ROAD PARIMENT MARKINGS AND SIGNAGE STA. 10+510 TO STA. 10+685 4 2018.02.28 35320-DWG-PM-203 TRANS CANADA WIDENING MARKINGS AND SIGNAGE 1 2018.02.28 35320-DWG-PM-203 RAILWAY CROSSING PLAN 4 2018.02.28 35320-DWG-DT-302 TRANS CANADA INTERSECTION DETAILS 4 2018.02.28 35320-DWG-DT-303 SOLSQUA ROAD INTERSECTION DETAILS 2 2018.02.28 35320-DWG-T3-401 TYPICAL CROSS SECTIONS 6 2018.02.2 35320-DWG-T3-402 TYPICAL CROSS SECTIONS 5 2018.04.27 35320-DWG-TM-501 TRANS CANADA HGHWAY REMOVAL PLAN STA. 10+360 TO STA. 10+360 5 2018.04.27 35320-DWG-RM-502 TRANS CANADA HGHWAY REMOVAL PLAN STA. 10+360 TO STA. 10+685 3 2018.04.27 35320-DWG-RM-503 SOLSQUA ROAD REMOVAL PLAN STA. 10+000 TO STA. 10+685 3 2018.04.27 35320-DWG-RM-501 TRANS CANADA HGHWAY REMOVAL PLAN STA. 10+360 TO STA. 10+68					
35320-DWG-PM-206 TRANS CANADA WIDENING MARKINGS AND SIGNAGE STA. 10+340 TO STA. 10+510 5 2018.02.28 35320-DWG-PM-207 TRANS CANADA WIDENING MARKINGS AND SIGNAGE STA. 10+510 TO STA. 10+685 4 2018.02.28 35320-DWG-FM-208 SOLSQUA ROAD PAVEMENT MARKINGS AND SIGNAGE 4 2018.02.28 35320-DWG-FA-301 RAILWAY CROSSING FLAN 4 2018.02.28 35320-DWG-FA-301 RAILWAY CROSSING FLAN 4 2018.02.28 35320-DWG-FD-303 SOLSQUA ROAD INTERSECTION DETAILS 3 2018.02.28 35320-DWG-FD-304 LINK ORDEWY INTERSECTION DETAILS 2 2018.02.28 35320-DWG-TS-401 TYPICAL CROSS SECTIONS 6 2018.03.22 35320-DWG-TS-401 TYPICAL CROSS SECTIONS 5 2018.04.27 35320-DWG-TS-403 TYPICAL CROSS SECTIONS 5 2018.04.27 35320-DWG-TS-403 TYPICAL CROSS SECTIONS 5 2018.04.27 35320-DWG-TS-403 TYPICAL CROSS SECTIONS 5 2018.04.27 35320-DWG-TS-401 TYPICAL CROSS SECTIONS 5 2018.04.27 35320-DWG-KS-601 CROSS SECTIONS - LINK ROAD REMOVAL P					
33320-DWG-PM-207 TRANS CANADA WIDENING MARKINGS AND SIGNAGE STA. 10+510 TO STA. 10+685 4 2018.02.28 35320-DWG-CR-301 RAILWAY CROSSING PLAN 4 2018.02.28 35320-DWG-DNG-CR-301 RAILWAY CROSSING PLAN 4 2018.02.28 35320-DWG-DNG-302 TRANS CANADA INTERSECTION DETAILS 4 2018.02.28 35320-DWG-DT-303 SOLSOUA ROAD INTERSECTION DETAILS 3 2018.04.27 35320-DWG-DT-304 LINK PREVENTY INTERSECTION DETAILS 2 2018.03.22 35320-DWG-TS-401 TYPICAL CROSS SECTIONS 6 2018.03.22 35320-DWG-TS-403 TYPICAL CROSS SECTIONS 6 2018.03.22 35320-DWG-RM-501 TRANS CANADA HICHWAY REMOVAL PLAN STA. 10+000 TO STA. 10+360 5 2018.04.27 35320-DWG-RM-502 TRANS CANADA HICHWAY REMOVAL PLAN STA. 10+000 TO STA. 10+360 5 2018.04.27 35320-DWG-RM-503 SOLSOLWA ROAD REMOVAL PLAN 4 2018.04.27 35320-DWG-RM-504 EXISTING LINK ROAD REMOVAL PLAN 4 2018.04.27 35320-DWG-KS-601 CROSS SECTIONS – LINK ROAD 4 2018.03.22 35320-DWG-KS-604					
35320-DWG-PM-208 SOLSQUA ROAD PAVEMENT MARKINGS AND SIGNAGE (7 2018.03.07 35320-DWG-CR-301 RAILWAY CROSSING PLAN 4 2018.02.28 35320-DWG-DT-302 TRANS CAMADA INTERSECTION DETAILS 4 2018.02.28 35320-DWG-DT-303 SOLSQUA ROAD INTERSECTION DETAILS 3 2018.02.28 35320-DWG-DT-304 LINK DRVEWAY INTERSECTION DETAILS 2 2018.02.28 35320-DWG-TS-401 TYPICAL CROSS SECTIONS 7 2018.03.22 35320-DWG-TS-403 TYPICAL CROSS SECTIONS 6 2018.03.22 35320-DWG-TS-403 TYPICAL CROSS SECTIONS 5 2018.04.27 35320-DWG-MS-501 TRANS CAMADA HIGHWAY REMOVAL PLAN STA. 10+000 TO STA. 10+360 5 2018.04.27 35320-DWG-RM-503 SOLSOUA ROAD REMOVAL PLAN 3 2018.02.28 35320-DWG-KS-601 CROSS SECTIONS - LINK ROAD 4 2018.02.28 35320-DWG-KS-601 CROSS SECTIONS - LINK ROAD 4 2018.03.22 35320-DWG-KS-602 CROSS SECTIONS - LINK ROAD 4 2018.03.22 35320-DWG-KS-604 CROSS SECTIONS - LINK ROAD 4			5		
Statu RAILWAY CROSSING PLAN 4 2018.02.28 35320-DWG-DT-302 TRANS CANADA INTERSECTION DETAILS 4 2018.02.28 35320-DWG-DT-303 SOLSQUA ROAD INTERSECTION DETAILS 3 2018.04.27 35320-DWG-DT-304 LINK DRIVEWAY INTERSECTION DETAILS 2 2018.02.28 35320-DWG-TS-401 TMPICAL CROSS SECTIONS 7 2018.03.22 35320-DWG-TS-402 TMPICAL CROSS SECTIONS 6 2018.04.27 35320-DWG-RM-501 TRANS CANADA HIGHWAY REMOVAL PLAN STA. 10+000 TO STA. 10+360 5 2018.04.27 35320-DWG-RM-502 TRANS CANADA HIGHWAY REMOVAL PLAN STA. 10+060 TO STA. 10+665 3 2018.02.28 35320-DWG-RM-503 SOLSQUA ROAD REMOVAL PLAN 3 2018.04.27 35320-DWG-RM-504 EXISTING S ELINK ROAD 4 2018.02.28 35320-DWG-RM-503 SOLSQUA ROAD REMOVAL PLAN 3 2018.04.27 35320-DWG-XS-604 CROSS SECTIONS - LINK ROAD 4 2018.03.22 35320-DWG-XS-605 CROSS SECTIONS - LINK ROAD 4 2018.03.22 35320-DWG-XS-606 CROSS SECTIONS - LINK ROAD 4			4		~~~~
35320-DWG-DT-302 TRANS CANADA INTERSECTION DETAILS 4 2018.02.28 35320-DWG-DT-303 SOLSQUA ROAD INTERSECTION DETAILS 3 2018.04.27 35320-DWG-TS-401 LINK DRIVEWAY INTERSECTION DETAILS 2 2018.02.28 35320-DWG-TS-401 TYPICAL CROSS SECTIONS 7 2018.03.22 35320-DWG-TS-402 TYPICAL CROSS SECTIONS 6 2018.03.22 35320-DWG-TS-402 TYPICAL CROSS SECTIONS 5 2018.04.27 35320-DWG-TS-402 TYPICAL CROSS SECTIONS 5 2018.04.27 35320-DWG-RM-501 TRANS CANADA HIGHWAY REMOVAL PLAN STA. 10+000 TO STA. 10+360 5 2018.04.27 35320-DWG-RM-503 SOLSQUA ROAD REMOVAL PLAN STA. 10+360 TO STA. 10+685 3 2018.02.28 35320-DWG-RM-504 EXISTINC LINK ROAD REMOVAL PLAN 3 2018.02.28 35320-DWG-XS-601 CROSS SECTIONS - LINK ROAD 4 2018.03.22 35320-DWG-XS-604 CROSS SECTIONS - LINK ROAD 4 2018.03.22 35320-DWG-XS-605 CROSS SECTIONS - LINK ROAD 4 2018.03.22 35320-DWG-XS-606 CROSS SECTIONS - TRANS CANADA <td< td=""><td></td><td></td><td>{</td><td>~~~~~~~~~~~~~~~~~~~~~~~~~~~~~~~~~~~~~~~</td><td>}</td></td<>			{	~~~~~~~~~~~~~~~~~~~~~~~~~~~~~~~~~~~~~~~	}
3520-DWG-DT-303 SOLSQUA ROAD INTERSECTION DETAILS 3 2018.04.27 35320-DWG-TS-401 LINK DRIVEWAY INTERSECTION DETAILS 2 2018.03.22 35320-DWG-TS-402 TYPICAL CROSS SECTIONS 7 2018.03.22 35320-DWG-TS-403 TYPICAL CROSS SECTIONS 6 2018.03.22 35320-DWG-TS-403 TYPICAL CROSS SECTIONS 5 2018.04.27 35320-DWG-TS-403 TYPICAL CROSS SECTIONS 5 2018.04.27 35320-DWG-RM-501 TRANS CANADA HIGHWAY REMOVAL PLAN STA. 10+000 TO STA. 10+360 5 2018.04.27 35320-DWG-RM-502 TRANS CANADA HIGHWAY REMOVAL PLAN STA. 10+360 TO STA. 10+685 3 2018.02.28 35320-DWG-RM-504 EXISTING LINK ROAD REMOVAL PLAN 3 2018.02.28 35320-DWG-XS-601 CROSS SECTIONS - LINK ROAD 5 2018.02.28 35320-DWG-XS-602 CROSS SECTIONS - LINK ROAD 4 2018.03.22 35320-DWG-XS-603 CROSS SECTIONS - LINK ROAD 4 2018.03.22 35320-DWG-XS-604 CROSS SECTIONS - LINK ROAD 4 2018.03.22 35320-DWG-XS-605 CROSS SECTIONS - LINK ROAD 4<	35320-DWG-CR-301	RAILWAY CROSSING PLAN	4	2018.02.28	
35320-DWG-DT-304 LINK DRIVEWAY INTERSECTION DETAILS 2 2018.02.28 35320-DWG-TS-401 TYPICAL CROSS SECTIONS 7 2018.03.22 35320-DWG-TS-402 TYPICAL CROSS SECTIONS 6 2018.03.22 35320-DWG-TS-403 TYPICAL CROSS SECTIONS 5 2018.04.27 35320-DWG-RM-501 TRANS CANADA HIGHWAY REMOVAL PLAN STA. 10+000 TO STA. 10+360 5 2018.04.27 35320-DWG-RM-502 TRANS CANADA HIGHWAY REMOVAL PLAN STA. 10+000 TO STA. 10+685 3 2018.04.27 35320-DWG-RM-503 SOLSQUA ROAD REMOVAL PLAN TA. 10+685 3 2018.04.27 35320-DWG-RM-504 EXISTING LINK ROAD REMOVAL PLAN TA. 10+685 3 2018.04.27 35320-DWG-RM-504 EXISTING LINK ROAD REMOVAL PLAN 3 2018.04.27 35320-DWG-XS-601 CROSS SECTIONS - LINK ROAD 4 2018.03.22 35320-DWG-XS-601 CROSS SECTIONS - LINK ROAD 4 2018.03.22 35320-DWG-XS-605 CROSS SECTIONS - LINK ROAD 4 2018.03.22 35320-DWG-XS-604 CROSS SECTIONS - LINK ROAD 4 2018.03.22 35320-DWG-XS-606 CROSS SECTIONS - TRANS CANADA <t< td=""><td>35320-DWG-DT-302</td><td></td><td>4</td><td>2018.02.28</td><td></td></t<>	35320-DWG-DT-302		4	2018.02.28	
35320-DWG-TS-401 TYPICAL CROSS SECTIONS 7 2018.03.22 35320-DWG-TS-402 TYPICAL CROSS SECTIONS 6 2018.03.22 35320-DWG-RM-501 TRANS CANADA HIGHWAY REMOVAL PLAN STA. 10+000 TO STA. 10+360 5 2018.04.27 35320-DWG-RM-501 TRANS CANADA HIGHWAY REMOVAL PLAN STA. 10+000 TO STA. 10+360 5 2018.04.27 35320-DWG-RM-501 TRANS CANADA HIGHWAY REMOVAL PLAN STA. 10+360 TO STA. 10+360 5 2018.04.27 35320-DWG-RM-503 SOLSQUA ROAD REMOVAL PLAN 4 2018.04.27 35320-DWG-RM-504 EXISTING LINK ROAD REMOVAL PLAN 3 2018.04.27 35320-DWG-XS-601 CROSS SECTIONS - LINK ROAD 4 2018.03.22 35320-DWG-XS-602 CROSS SECTIONS - LINK ROAD 4 2018.03.22 35320-DWG-XS-603 CROSS SECTIONS - LINK ROAD 4 2018.03.22 35320-DWG-XS-604 CROSS SECTIONS - LINK ROAD 4 2018.03.22 35320-DWG-XS-605 CROSS SECTIONS - LINK ROAD 4 2018.03.22 35320-DWG-XS-606 CROSS SECTIONS - TRANS CANADA 4 2018.03.22 35320-DWG-XS-607 CROSS SECTIONS -	35320-DWG-DT-303	SOLSQUA ROAD INTERSECTION DETAILS	3	2018.04.27	
35320-DWG-TS-402 TYPICAL CROSS SECTIONS 6 2018.03.22 35320-DWG-TS-403 TYPICAL CROSS SECTIONS 5 2018.04.27 35320-DWG-RM-501 TRANS CANADA HIGHWAY REMOVAL PLAN STA. 10+000 TO STA. 10+360 5 2018.04.27 35320-DWG-RM-502 TRANS CANADA HIGHWAY REMOVAL PLAN STA. 10+000 TO STA. 10+685 3 2018.02.28 35320-DWG-RM-502 TRANS CANADA HIGHWAY REMOVAL PLAN STA. 10+360 TO STA. 10+685 3 2018.02.28 35320-DWG-RM-504 EXISTING LINK ROAD REMOVAL PLAN 3 2018.02.28 35320-DWG-SK-601 CROSS SECTIONS - LINK ROAD 4 2018.03.22 35320-DWG-XS-601 CROSS SECTIONS - LINK ROAD 4 2018.03.22 35320-DWG-XS-604 CROSS SECTIONS - TRANS CANADA 4 2018.03.22 35320-DWG-XS-605 CROSS SECTIONS - TRANS CANADA 4 2018.03.22 35320-DWG-XS-604 CROSS SECTIO	35320-DWG-DT-304	LINK DRIVEWAY INTERSECTION DETAILS	2	2018.02.28	
35320-DWG-TS-403 TYPICAL CROSS SECTIONS 5 2018.04.27 35320-DWG-RM-501 TRANS CANADA HIGHWAY REMOVAL PLAN STA. 10+000 TO STA. 10+360 5 2018.04.27 35320-DWG-RM-502 TRANS CANADA HIGHWAY REMOVAL PLAN STA. 10+360 TO STA. 10+685 3 2018.02.28 35320-DWG-RM-503 SOLSQUA ROAD REMOVAL PLAN 4 2018.02.28 35320-DWG-RM-504 EXISTING LINK ROAD REMOVAL PLAN 3 2018.02.28 35320-DWG-SS-601 CROSS SECTIONS - LINK ROAD 4 2018.03.22 35320-DWG-XS-601 CROSS SECTIONS - LINK ROAD 4 2018.03.22 35320-DWG-XS-604 CROSS SECTIONS - LINK ROAD 4 2018.03.22 35320-DWG-XS-605 CROSS SECTIONS - LINK ROAD 4 2018.03.22 35320-DWG-XS-604 CROSS SECTIONS - LINK ROAD 4 2018.03.22 35320-DWG-XS-605 CROSS SECTIONS - LINK ROAD 4 2018.03.22 35320-DWG-XS-606 CROSS SECTIONS - LINK ROAD 4 2018.03.22 35320-DWG-XS-606 CROSS SECTIONS - TRANS CANADA 4 2018.03.22 35320-DWG-XS-607 CROSS SECTIONS - TRANS CANADA <td< td=""><td>35320-DWG-TS-401</td><td>TYPICAL CROSS SECTIONS</td><td>7</td><td>2018.03.22</td><td></td></td<>	35320-DWG-TS-401	TYPICAL CROSS SECTIONS	7	2018.03.22	
35320-DWG-RM-501 TRANS CANADA HIGHWAY REMOVAL PLAN STA. 10+000 TO STA. 10+360 5 2018.04.27 35320-DWG-RM-502 TRANS CANADA HIGHWAY REMOVAL PLAN STA. 10+360 TO STA. 10+685 3 2018.02.28 35320-DWG-RM-503 SOLSQUA ROAD REMOVAL PLAN 4 2018.02.28 35320-DWG-RM-504 EXISTING LINK ROAD REMOVAL PLAN 3 2018.02.28 35320-DWG-XS-601 CROSS SECTIONS - LINK ROAD 5 2018.04.27 35320-DWG-XS-602 CROSS SECTIONS - LINK ROAD 4 2018.03.22 35320-DWG-XS-604 CROSS SECTIONS - LINK ROAD 4 2018.03.22 35320-DWG-XS-604 CROSS SECTIONS - LINK ROAD 4 2018.03.22 35320-DWG-XS-605 CROSS SECTIONS - LINK ROAD 4 2018.03.22 35320-DWG-XS-604 CROSS SECTIONS - TRANS CANADA 4 2018.03.22 35320-DWG-XS-605 CROSS SECTIONS - TRANS CANADA 4 2018.03.22 35320-DWG-XS-604 CROSS SECTIONS - TRANS CANADA 4 2018.03.22 35320-DWG-XS-605 CROSS SECTIONS - TRANS CANADA 4 2018.03.22 35320-DWG-XS-610 CROSS SECTIONS - TRANS CANADA <td>35320-DWG-TS-402</td> <td>TYPICAL CROSS SECTIONS</td> <td>6</td> <td>2018.03.22</td> <td></td>	35320-DWG-TS-402	TYPICAL CROSS SECTIONS	6	2018.03.22	
35320-DWG-RM-502 TRANS CANADA HIGHWAY REMOVAL PLAN STA. 10+360 TO STA. 10+685 3 2018.02.28 35320-DWG-RM-503 SOLSQUA ROAD REMOVAL PLAN 4 2018.04.27 35320-DWG-RM-504 EXISTING LINK ROAD REMOVAL PLAN 3 2018.02.28 35320-DWG-RM-504 EXISTING LINK ROAD REMOVAL PLAN 3 2018.02.28 35320-DWG-XS-601 CROSS SECTIONS - LINK ROAD 4 2018.03.22 35320-DWG-XS-603 CROSS SECTIONS - LINK ROAD 4 2018.03.22 35320-DWG-XS-604 CROSS SECTIONS - LINK ROAD 4 2018.03.22 35320-DWG-XS-605 CROSS SECTIONS - LINK ROAD 4 2018.03.22 35320-DWG-XS-606 CROSS SECTIONS - LINK ROAD 4 2018.03.22 35320-DWG-XS-606 CROSS SECTIONS - TRANS CANADA 4 2018.03.22 35320-DWG-XS-606 CROSS SECTIONS - TRANS CANADA 4 2018.03.22 35320-DWG-XS-607 CROSS SECTIONS - TRANS CANADA 4 2018.03.22 35320-DWG-XS-608 CROSS SECTIONS - TRANS CANADA 4 2018.03.22 35320-DWG-XS-610 CROSS SECTIONS - TRANS CANADA 4	35320-DWG-TS-403	TYPICAL CROSS SECTIONS	5	2018.04.27	
35320-DWG-RM-503 SOLSQUA ROAD REMOVAL PLAN 4 2018.04.27 35320-DWG-RM-504 EXISTING LINK ROAD REMOVAL PLAN 3 2018.02.28 35320-DWG-XS-601 CROSS SECTIONS - LINK ROAD 5 2018.04.27 35320-DWG-XS-602 CROSS SECTIONS - LINK ROAD 4 2018.03.22 35320-DWG-XS-603 CROSS SECTIONS - LINK ROAD 4 2018.03.22 35320-DWG-XS-604 CROSS SECTIONS - LINK ROAD 4 2018.03.22 35320-DWG-XS-605 CROSS SECTIONS - LINK ROAD 4 2018.03.22 35320-DWG-XS-606 CROSS SECTIONS - LINK ROAD 4 2018.03.22 35320-DWG-XS-606 CROSS SECTIONS - TRANS CANADA 4 2018.03.22 35320-DWG-XS-606 CROSS SECTIONS - TRANS CANADA 4 2018.03.22 35320-DWG-XS-607 CROSS SECTIONS - TRANS CANADA 4 2018.03.22 35320-DWG-XS-609 CROSS SECTIONS - TRANS CANADA 4 2018.03.22 35320-DWG-XS-610 CROSS SECTIONS - TRANS CANADA 4 2018.03.22 35320-DWG-XS-611 CROSS SECTIONS - TRANS CANADA 4 2018.03.22 <t< td=""><td>35320-DWG-RM-501</td><td>TRANS CANADA HIGHWAY REMOVAL PLAN STA. 10+000 TO STA. 10+360</td><td>5</td><td>2018.04.27</td><td></td></t<>	35320-DWG-RM-501	TRANS CANADA HIGHWAY REMOVAL PLAN STA. 10+000 TO STA. 10+360	5	2018.04.27	
35320 - DWG - RM - 504 EXISTING LINK ROAD REMOVAL PLAN 3 2018.02.28 35320 - DWG - XS - 601 CROSS SECTIONS - LINK ROAD 5 2018.04.27 35320 - DWG - XS - 602 CROSS SECTIONS - LINK ROAD 4 2018.03.22 35320 - DWG - XS - 603 CROSS SECTIONS - LINK ROAD 4 2018.03.22 35320 - DWG - XS - 604 CROSS SECTIONS - LINK ROAD 4 2018.03.22 35320 - DWG - XS - 604 CROSS SECTIONS - LINK ROAD 4 2018.03.22 35320 - DWG - XS - 604 CROSS SECTIONS - LINK ROAD 4 2018.03.22 35320 - DWG - XS - 604 CROSS SECTIONS - TRANS CANADA 4 2018.03.22 35320 - DWG - XS - 606 CROSS SECTIONS - TRANS CANADA 4 2018.03.22 35320 - DWG - XS - 607 CROSS SECTIONS - TRANS CANADA 4 2018.03.22 35320 - DWG - XS - 608 CROSS SECTIONS - TRANS CANADA 4 2018.03.22 35320 - DWG - XS - 610 CROSS SECTIONS - TRANS CANADA 4 2018.03.22 35320 - DWG - XS - 611 CROSS SECTIONS - TRANS CANADA 4 2018.03.22 35320 - DWG - XS - 613 CROSS SECT	35320-DWG-RM-502	TRANS CANADA HIGHWAY REMOVAL PLAN STA. 10+360 TO STA. 10+685	3	2018.02.28	
35320-DWG-XS-601 CROSS SECTIONS - LINK ROAD 5 2018.04.27 35320-DWG-XS-602 CROSS SECTIONS - LINK ROAD 4 2018.03.22 35320-DWG-XS-603 CROSS SECTIONS - LINK ROAD 4 2018.03.22 35320-DWG-XS-604 CROSS SECTIONS - LINK ROAD 4 2018.03.22 35320-DWG-XS-604 CROSS SECTIONS - LINK ROAD 4 2018.03.22 35320-DWG-XS-605 CROSS SECTIONS - LINK ROAD 4 2018.03.22 35320-DWG-XS-606 CROSS SECTIONS - TRANS CANADA 4 2018.03.22 35320-DWG-XS-607 CROSS SECTIONS - TRANS CANADA 4 2018.03.22 35320-DWG-XS-608 CROSS SECTIONS - TRANS CANADA 4 2018.03.22 35320-DWG-XS-609 CROSS SECTIONS - TRANS CANADA 4 2018.03.22 35320-DWG-XS-610 CROSS SECTIONS - TRANS CANADA 4 2018.03.22 35320-DWG-XS-610 CROSS SECTIONS - TRANS CANADA 4 2018.03.22 35320-DWG-XS-611 CROSS SECTIONS - TRANS CANADA 4 2018.03.22 35320-DWG-XS-612 CROSS SECTIONS - TRANS CANADA 4 2018.04.27	35320-DWG-RM-503	SOLSQUA ROAD REMOVAL PLAN	4	2018.04.27	
	35320-DWG-XS-615	CROSS SECTIONS – SOLSQUA ROAD	5	2018.04.27	
35320-DWG-XS-617 CROSS SECTIONS - DRIVEWAY 2018.03.22	35320-DWG-XS-616	CROSS SECTIONS – SOLSQUA ROAD	5	2018.04.27	
	35320-DWG-XS-617	CROSS SECTIONS – DRIVEWAY	4	2018.03.22	
35320-DWG-XS-618 CROSS SECTIONS - DRIVEWAY 4 2018.03.22	35320-DWG-XS-618	CROSS SECTIONS – DRIVEWAY	4		

		PROFESSIONAL SEALS	9	2018.05.07	ISSUED FOR CONSTRUCTION - REVISED	GP	
	ТСН		8	2018.04.27	ISSUED FOR CONSTRUCTION - REVISED	GP	
			7	2018.03.22	ISSUED FOR CONSTRUCTION - REVISED	GP	
METRIC		ORIGINAL SEALED	6	2018.02.28	ISSUED FOR CONSTRUCTION - REVISED	GP	
UNLESS OTHERWISE NOT		G.S. POOLE 2018.05.07	5	2018.01.26	ISSUED FOR CONSTRUCTION - REVISED	GP	
DESIGNED BY: GP	DRAWN BY:	SEE SCANNED COPY	4	2017.12.08	ISSUED FOR CONSTRUCTION - REVISED	GP	
DATE: 2018.05.07	DATE: 2018.05.07	And and a second s	3	2017.11.24	ISSUED FOR CONSTRUCTION - REVISED	GP	
CHECKED BY: ST	PROJECT MANAGER:		2	2017.11.06	ISSUED FOR CONSTRUCTION - REVISED	GP	PROJECT SERV
DATE: 2018.05.07	DATE: 2018.05.07		1	2017.10.16	ISSUED FOR CONSTRUCTION	GP	ENGINEERING S
HATCH PROJECT No:	DWG SCALE(22X34):	This document should not be relied on or used in circumstances other than those for which it was originally prepared and for which Hatch Corporation was	0	2017.07.26	ISSUED FOR TENDER	К.М.М.	
352320		This document should not be relied on or used in circumstances other than those for which it was originally prepared and for which Hatch Corporation was commissioned. Hatch Corporation accepts no responsibility for this document to any party other than the person by whom it was commissioned.	No.	DATE	REVISION	BY	

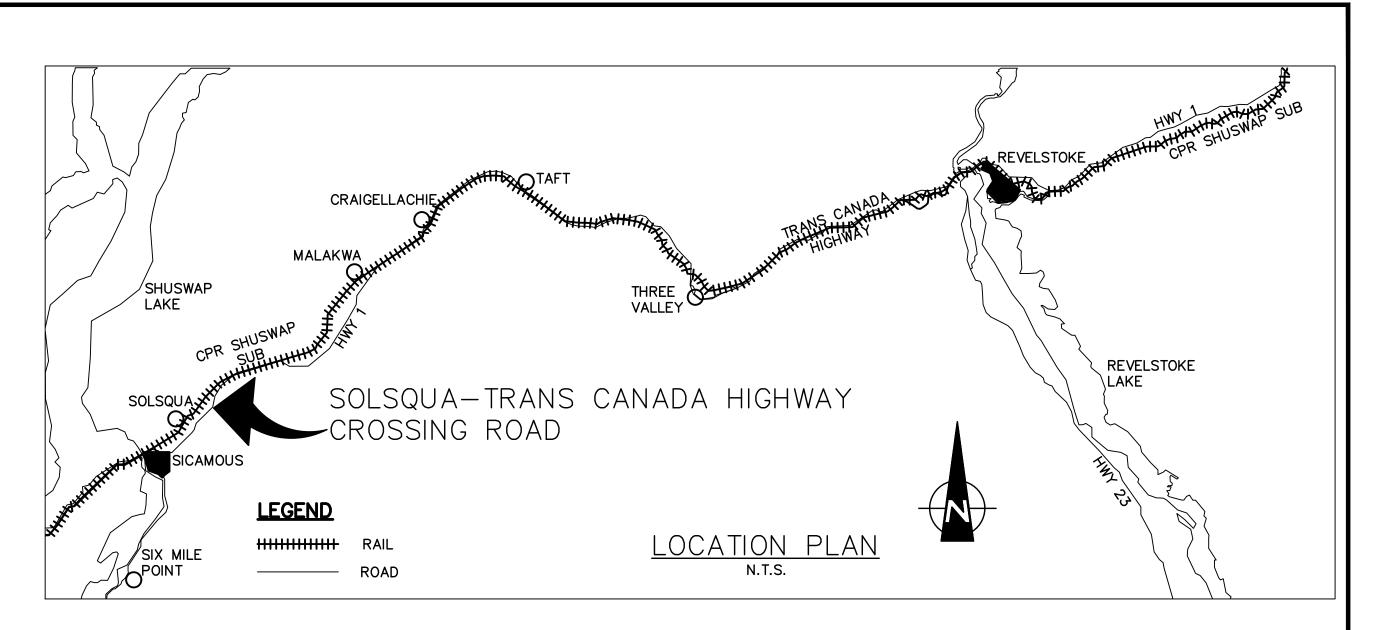

GENERAL NOTES

- 1. ALL UNITS ARE METRIC (METRES) UNLESS NOTED OTHERWISE.
- 2. ALL PROPERTY LINES ARE PROVIDED FOR INFORMATION ONLY.
- 3. SHOULD THE CONTRACTOR FIND ANY DISCREPANCIES ON THE DRAWINGS, OR IN THE FIELD PRIOR TO BEGINNING WORK OR DURING CONSTRUCTION, THEY SHALL IMMEDIATELY NOTIFY THE ENGINEER.
- 4. ALL CONSTRUCTION MATERIALS AND METHODS TO BE IN ACCORDANCE WITH BRITISH COLUMBIA 2016 STANDARD SPECIFICATIONS FOR HIGHWAY CONSTRUCTION.
- 5. NO WORK WILL BE DONE WITHIN THE CP RIGHT-OF-WAY WITHOUT PRIOR APPROVAL FROM CP.
- 6. ALL CONSTRUCTION WITHIN THE CP RIGHT-OF-WAY SHALL MEET CURRENT CP STANDARD SPECIFICATIONS.
- 7. THE CONTRACTOR IS RESPONSIBLE FOR LOCATING AND VERIFYING ALL UNDERGROUND UTILITIES PRIOR TO CONSTRUCTION.
- 8. THE CONTRACTOR SHALL TAKE NECESSARY PRECAUTIONS TO PREVENT DAMAGE TO EXISTING UTILITIES AND TREES.
- 9. THE CONTRACTOR IS REQUIRED TO MEET ALL APPLICABLE FEDERAL, PROVINCIAL, AND LOCAL REGULATIONS CONCERNING PROJECT SAFETY & ASSUME FULL RESPONSIBILITY FOR SAFETY ON THE PROJECT.
- 10. CROSSING PLANKS TO BE INSTALLED BY OTHERS.


<u>LEGEND</u>

_ _ _ _ _ _ _ _ _ _


<u> </u>
BOF
TOC
R/W
•
• •
$\checkmark \checkmark \checkmark \checkmark$
-
0707070701

EXISTING RIGHT OF WAY EXISTING CP RAIL TRACKS CP RAIL TRACKS EXISTING LANE EDGE LANE EDGE EXISTING SHOULDER EDGE SHOULDER BOTTOM OF DITCH FENCE ROAD CENTRE LINE LIMIT OF GRADING (BOF/TOC) BOTTOM OF FILL TOP OF CUT RIGHT OF WAY ONE POST ROAD SIGN TWO POST ROAD SIGN EXISTING POWER POLE PROPOSED POWER POLE INFORMATION DIRECTIONAL ARROWS PAINTED DIRECTIONAL ARROWS ASPHALT PAVEMENT - NEW CONSTRUCTION MILL AND INLAY 50mm GRAVEL SURFACE - NEW CONSTRUCTION REMOVE EXISTING PAVEMENT

	MOUNTAIN	DIVISION		SHUSWAP SUB.
			CROSSING ROA LIST & LEGEN	
	DWG. BY:	CHK BY:	OFFICE FILE:	
VICES - CALGARY SERVICES			SCALE:	
	ENGINEER:		DATE:	
	l. pereira Manager P	ROJECTS	PLAN No. 352320-DWG-HIN	1–002 R ev. 9

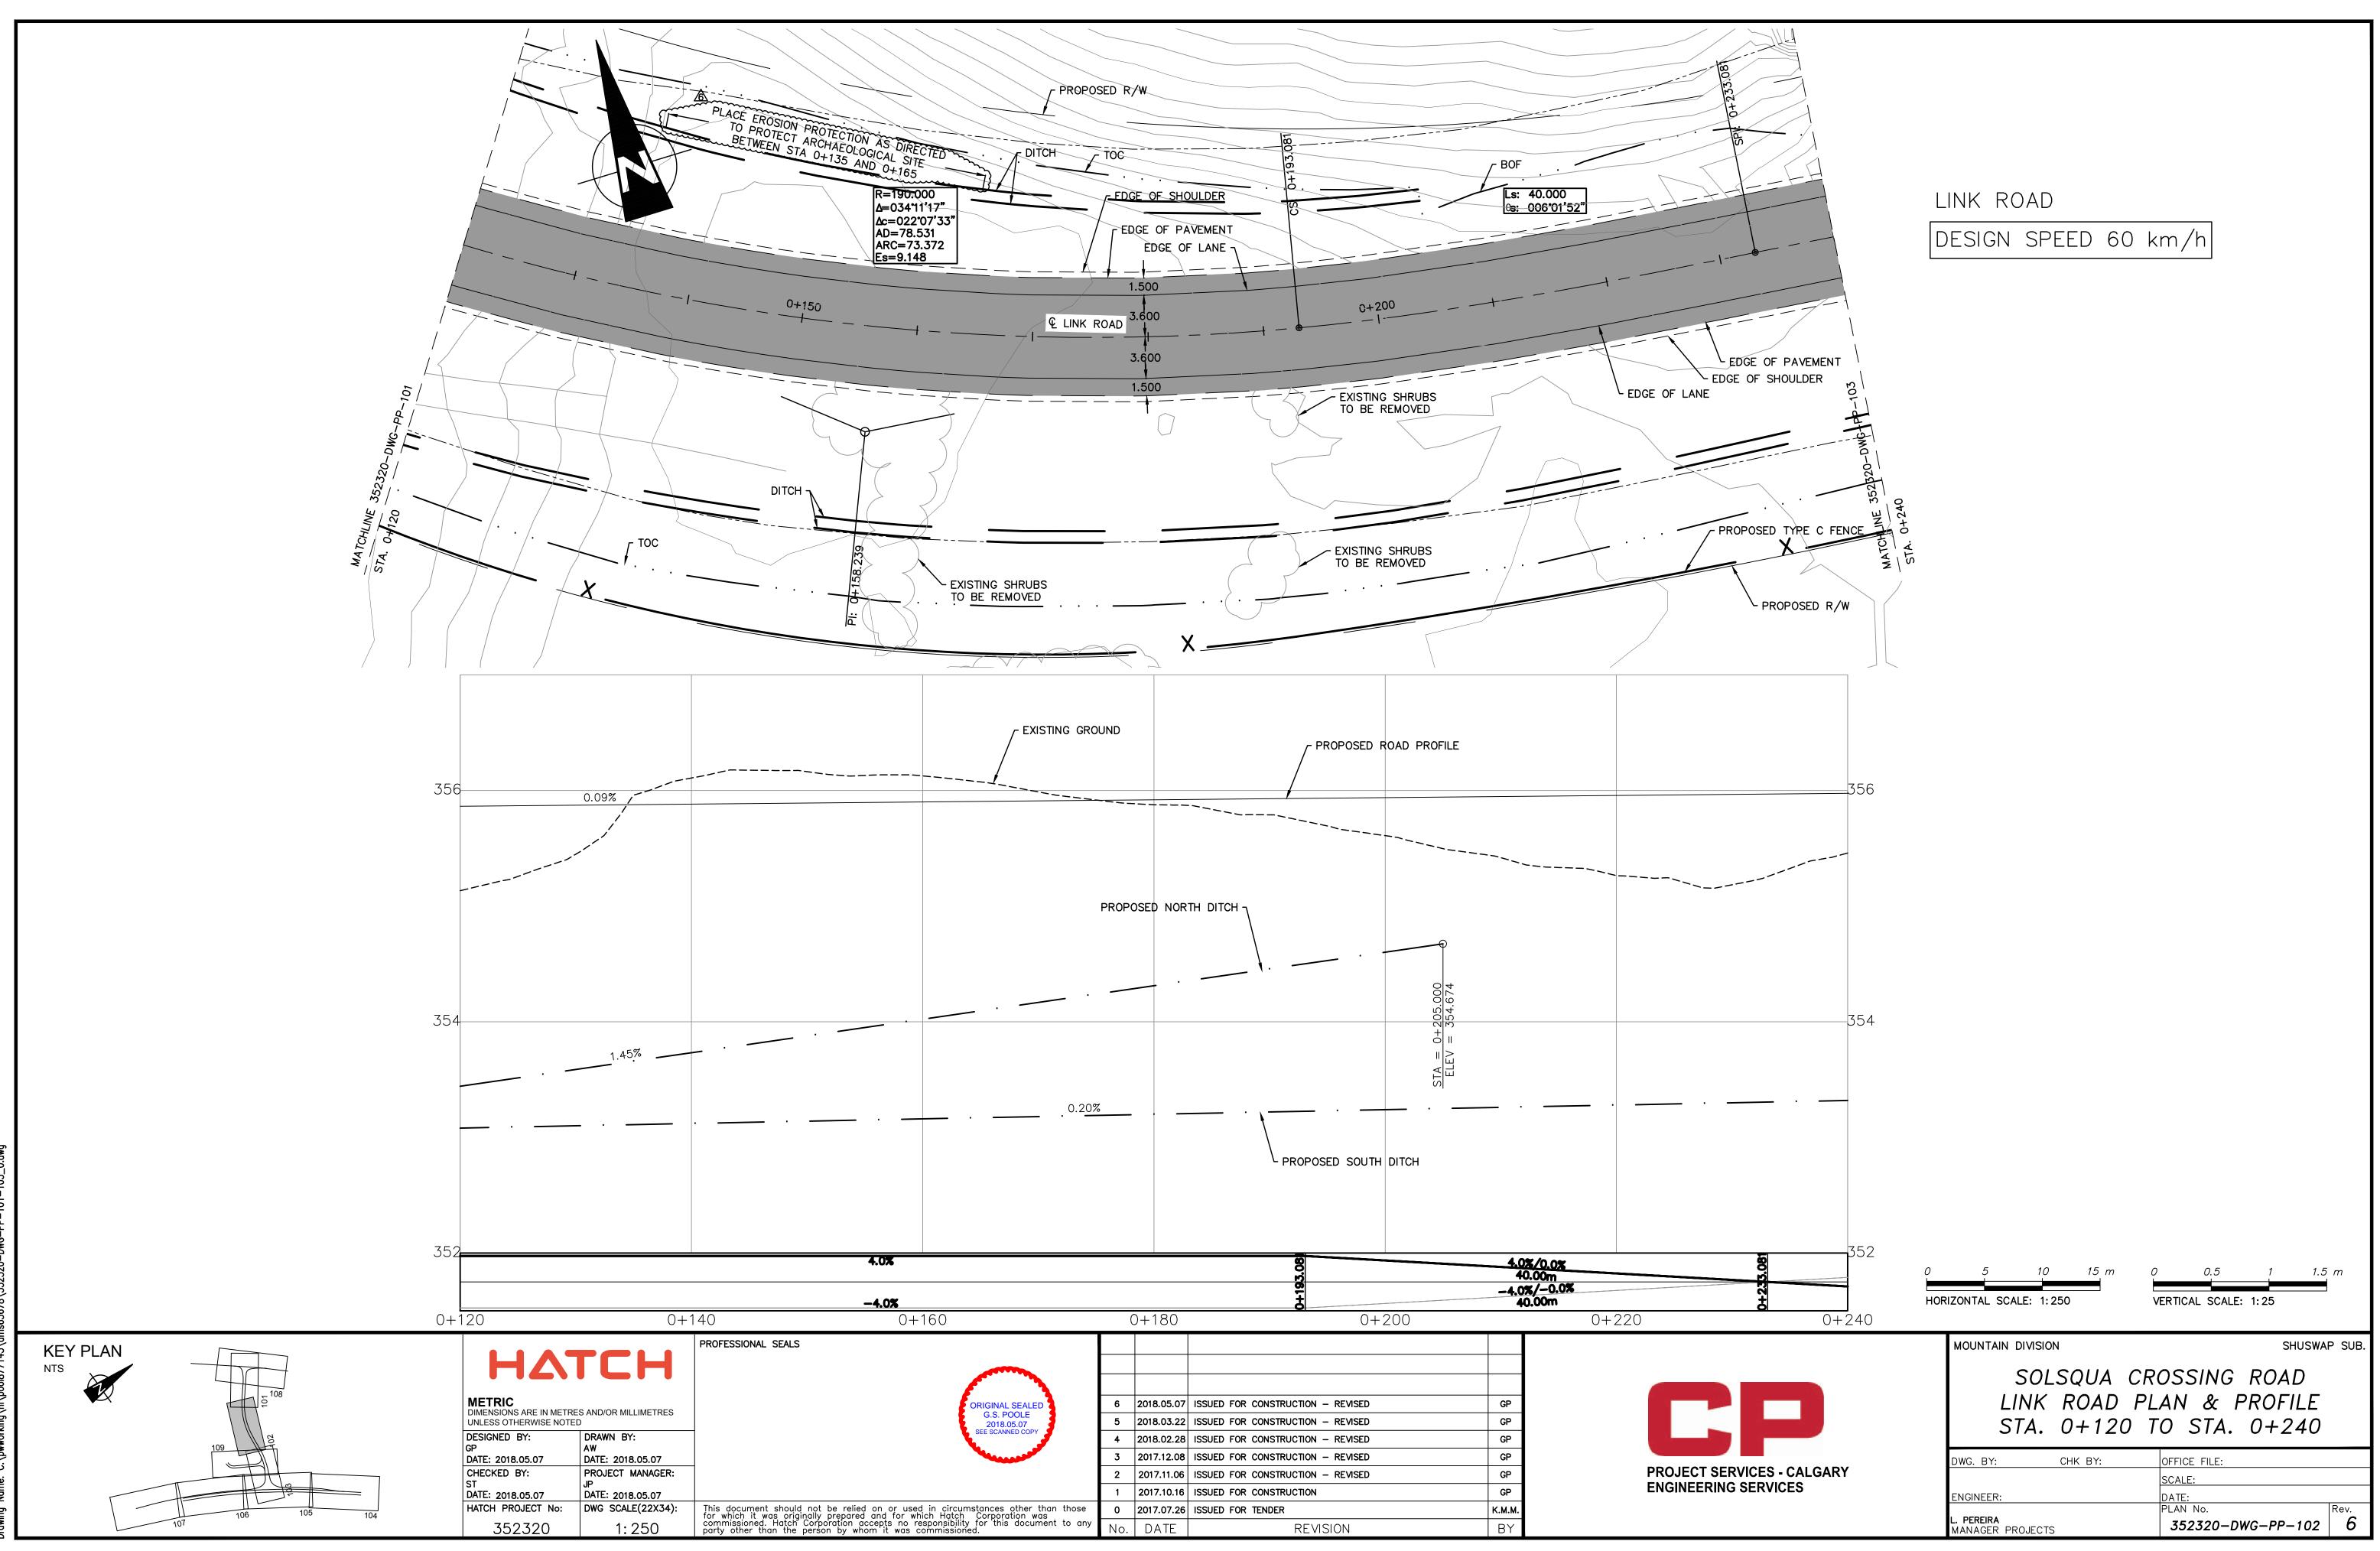

07,2018,3:29pm Login name: POOL877145 ing Name: C:\pwworking\hi\pool877145\dms65678\352320-DWG-PP-101-10;

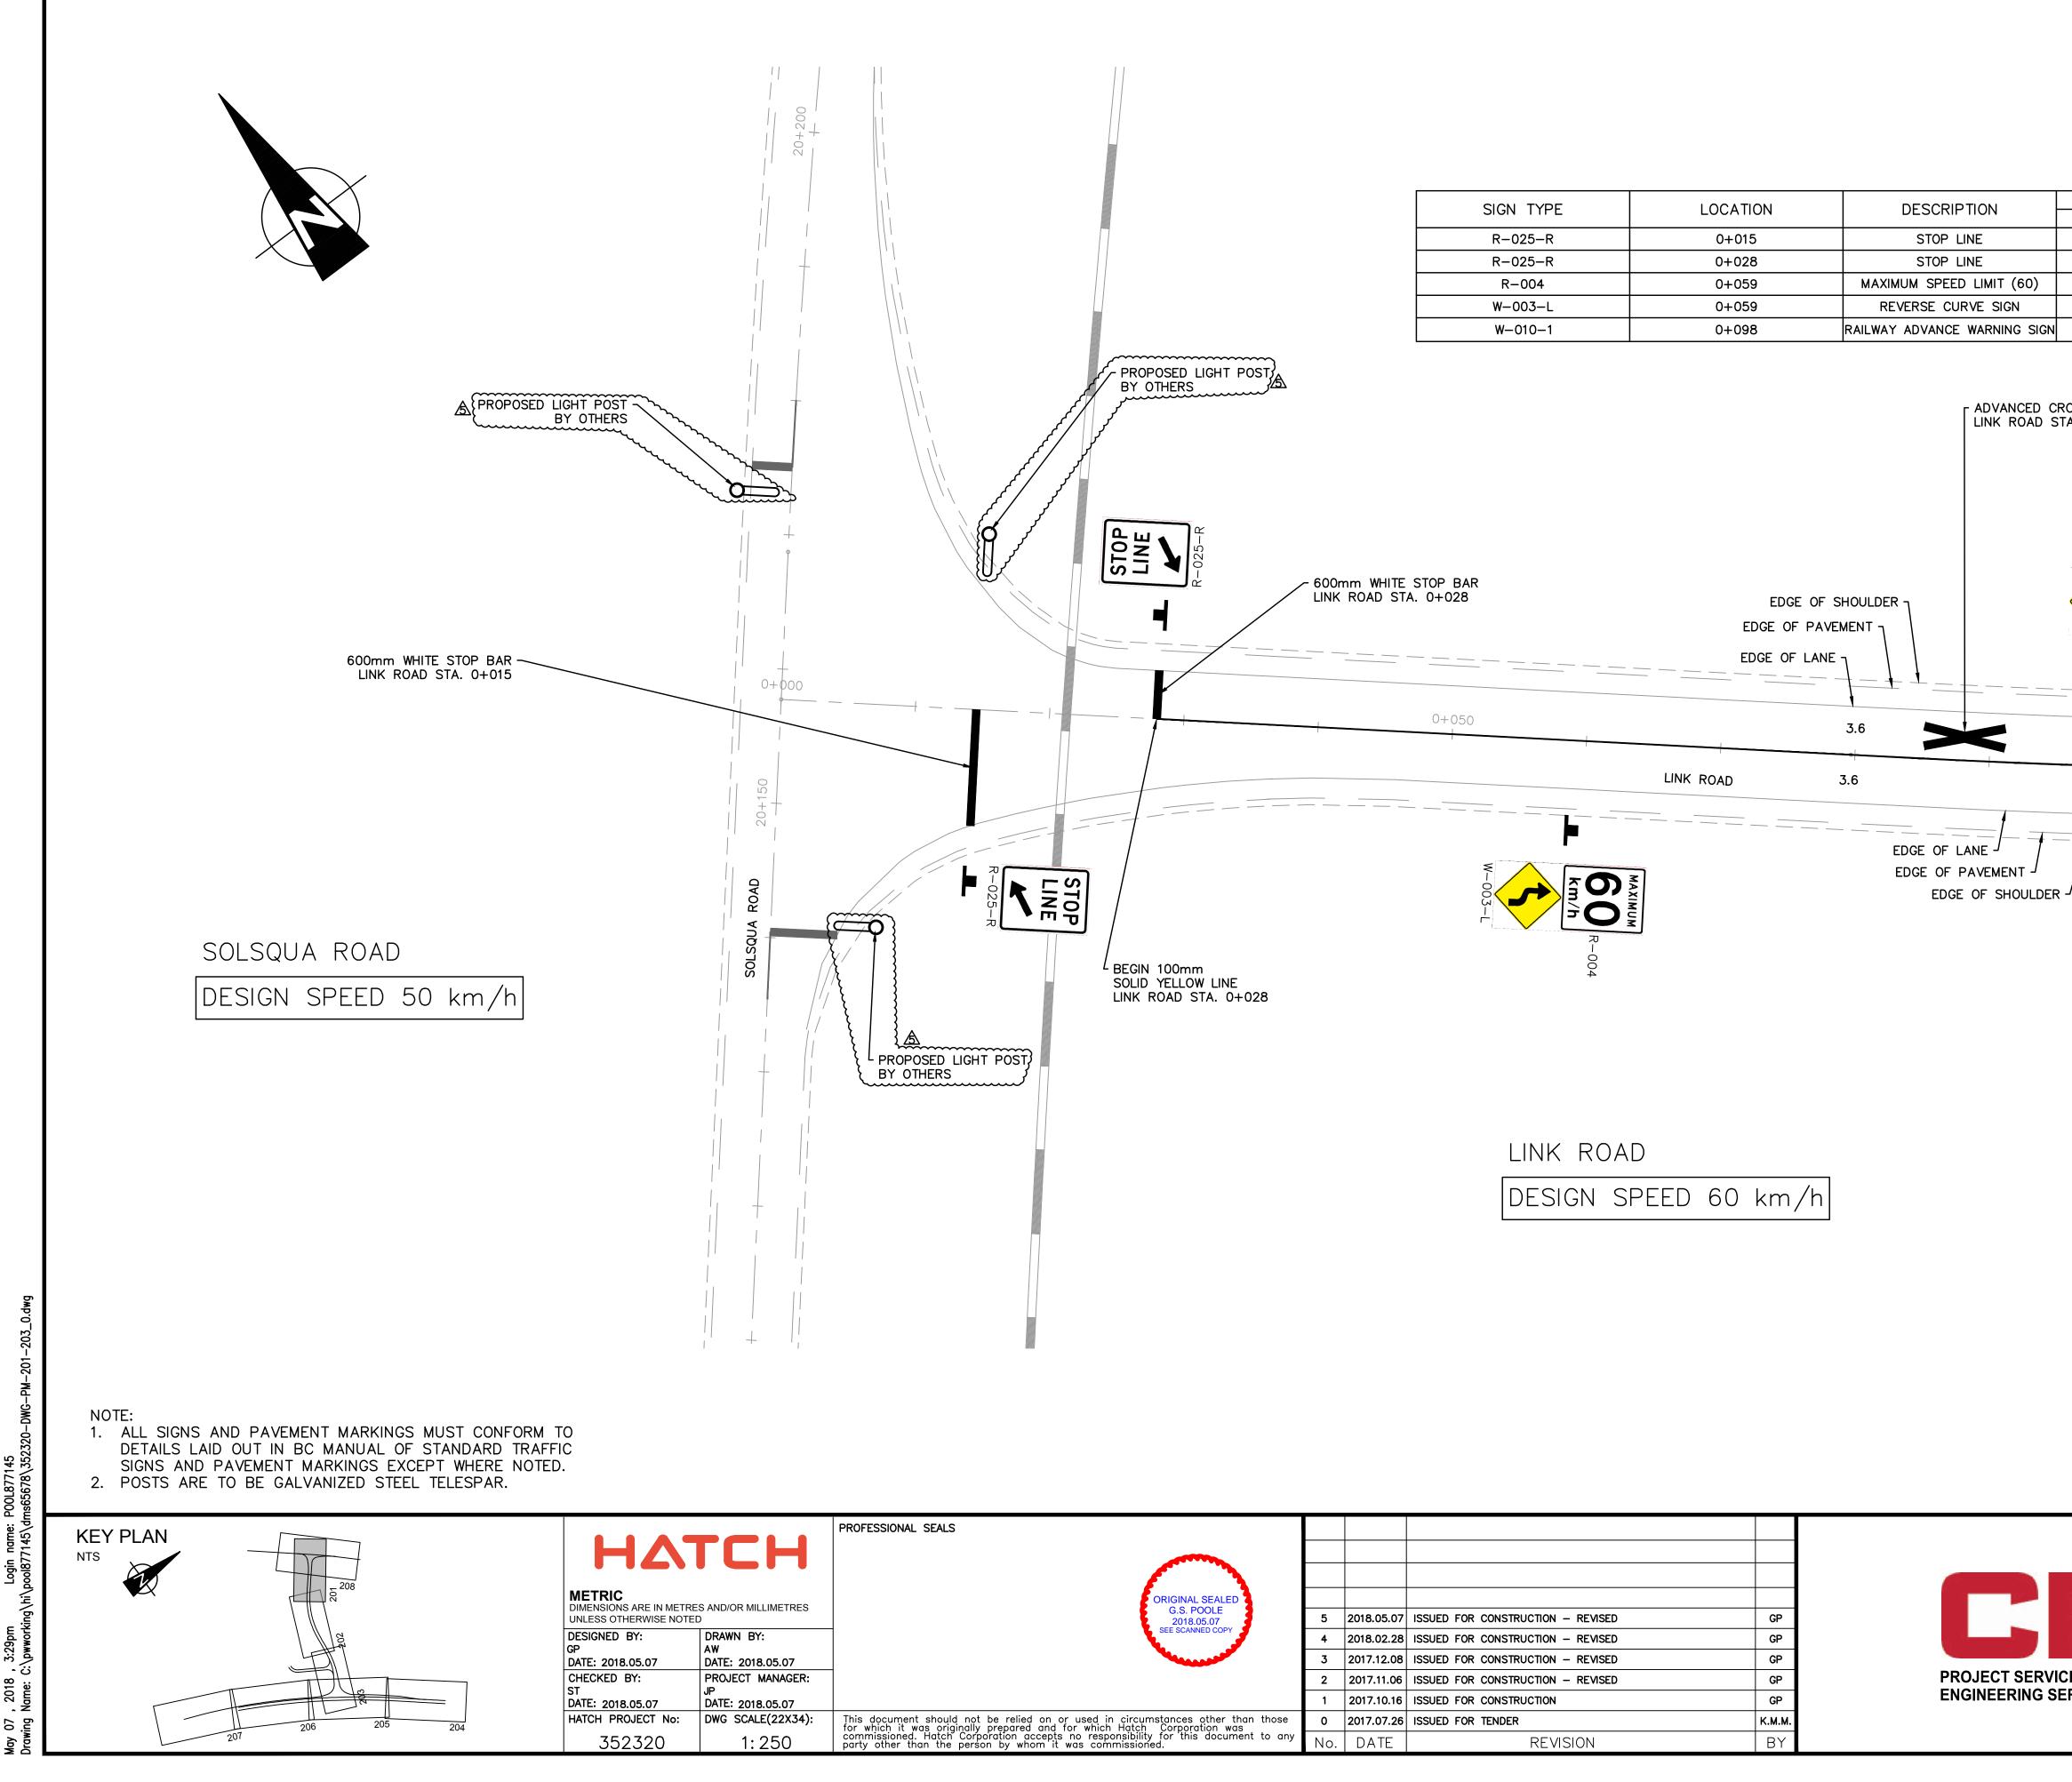


P00L8771 , 3:291 C:\pwwe , 2018 Name: 1 07 ving

			DESCRIPTION			
	SIGN TYPE	LOCATION	DESCRIPTION			
	R-025-R	0+015	STOP LINE			
	R-025-R	0+028	STOP LINE			
	R-004	0+059	MAXIMUM SPEED LIMIT (60)			
	W-003-L	0+059	REVERSE CURVE SIGN			
	W-010-1	0+098	RAILWAY ADVANCE WARNING SIGN			

ORIGINAL SEALED					
G.S. POOLE 2018.05.07	5	2018.05.07	ISSUED FOR CONSTRUCTION - REVISED	GP	
SEE SCANNED COPY	4	2018.02.28	ISSUED FOR CONSTRUCTION - REVISED	GP	
The second se	3	2017.12.08	ISSUED FOR CONSTRUCTION - REVISED	GP	
	2	2017.11.06	ISSUED FOR CONSTRUCTION - REVISED	GP	
	1	2017.10.16	ISSUED FOR CONSTRUCTION	GP	
e relied on or used in circumstances other than those repared and for which Hatch Corporation was	0	2017.07.26	ISSUED FOR TENDER	К.М.М.	
e relied on or used in circumstances other than those repared and for which Hatch Corporation was ation accepts no responsibility for this document to any by whom it was commissioned.	No.	DATE	REVISION	BY	

NO. REQUIRED				
SIGNS POSTS				
1 1				
1 1 1 0				
1 1				
· · · · · · · · · · · · · · · · · · ·				
ROSSING MARKING TA. 0+088				
W-010-1				
7 				
0+100				
	02			
	- PP - 2			
	-DWG-			
	352320			
	MATCHLINE 352320-DWG-PP-202 STA. 0+120			
	STA.			
		10 15	~~~	
	5 0 5 SCALE: 1:250	10 15	20 .	25 m
	MOUNTAIN DIVISION		SHUSWAF	> SUB.
	SOLSQUA (
	LINK ROAD PAVEMEN STA. 0+000			VAGE
	DWG. BY: CHK BY:	OFFICE FILE:		
CES - CALGARY ERVICES	ENGINEER:	SCALE: DATE:		
	L. PEREIRA MANAGER PROJECTS	PLAN No.	VG-PM-201	^{Rev.} 5

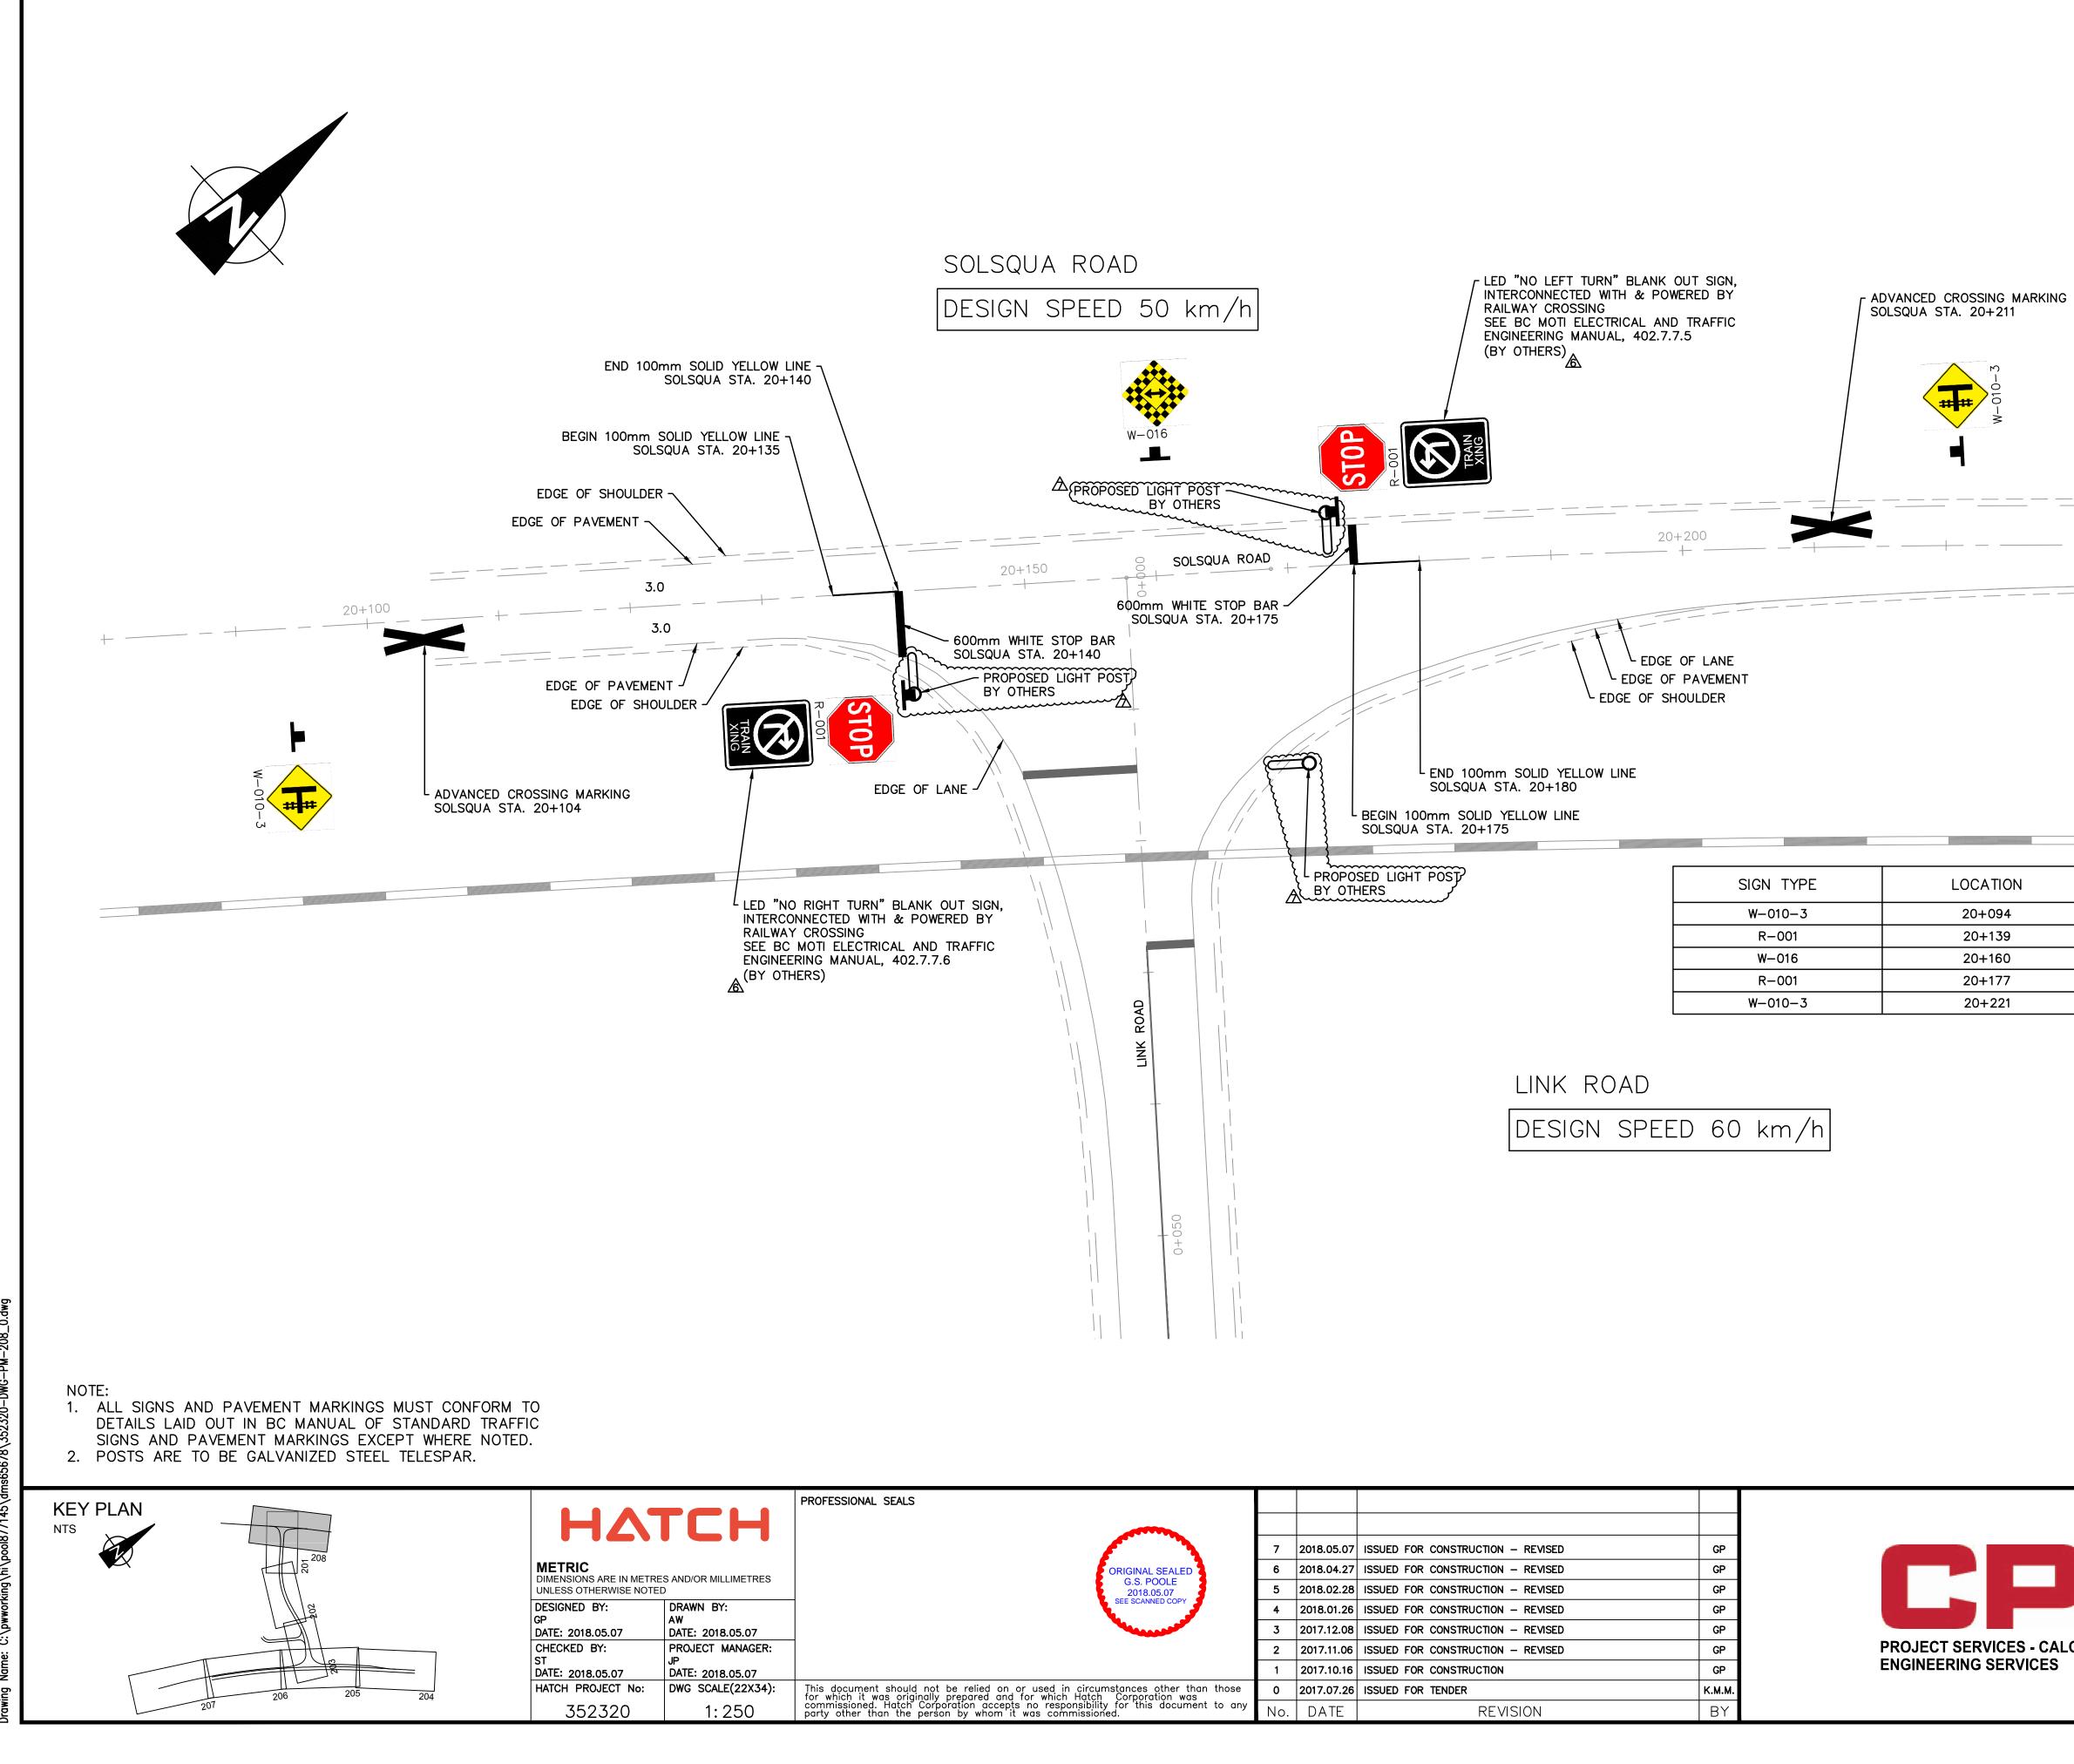

ъ j POOL8771 · ن , 2018 Name: 07 Ing

	7	2018.05.07	ISSUED FOR CONSTRUCTION - REVISED	GP	
ORIGINAL SEALED	6	2018.04.27	ISSUED FOR CONSTRUCTION - REVISED	GP	
G.S. POOLE 2018.05.07	5	2018.02.28	ISSUED FOR CONSTRUCTION - REVISED	GP	
SEE SCANNED COPY	4	2018.01.26	ISSUED FOR CONSTRUCTION - REVISED	GP	
A A A A A A A A A A A A A A A A A A A	3	2017.12.08	ISSUED FOR CONSTRUCTION - REVISED	GP	
	2	2017.11.06	ISSUED FOR CONSTRUCTION - REVISED	GP	PRC
	1	2017.10.16	ISSUED FOR CONSTRUCTION	GP	ENG
be relied on or used in circumstances other than those prepared and for which Hatch Corporation was	0	2017.07.26	ISSUED FOR TENDER	K.M.M.	
be relied on or used in circumstances other than those prepared and for which Hatch Corporation was poration accepts no responsibility for this document to any on by whom it was commissioned.	No.	DATE	REVISION	BY	



_____ 3.0 20+250 3.0

ION	DESCRIPTION	NO. REQUIRED			
	DESCRIPTION	SIGNS	POSTS		
94	RAILWAY ADVANCE WARNING SIGN	1	1		
39	STOP SIGN	1	(O (LIGHT POST)		
60	CHECKERBOARD SIGN	1	1		
77	STOP SIGN	1	(O (LIGHT POST)		
21	RAILWAY ADVANCE WARNING SIGN	1	1		

	5	0	5	10	15	20	25 m
	SCALE	: 1:250					1
	MOUNTAIN DI	VISION				SHUSW	IAP SUB.
	SOLSQUA	OLSQU, ROAD PA A. O+O	VEMEI	NT MAR	RKINGS	AND S	
	DWG. BY:	CHK BY:		OFFICE F	ILE:		
S - CALGARY VICES	ENGINEER:			<u>SCALE:</u> DATE:			
	L. PEREIRA MANAGER PROJ	JECTS		PLAN No		-PM-208	B Rev.